


OWNER		PLAN OF TITLE		Registered Number
FOLIO REFERENCE C.T. 4324-34		LOCATION DORSET - BLANDFORD		P.198058
GRANTEE		FIRST SURVEY PLAN No. D.24690, 7/2DOR, 504/8b.		APPROVED 11 APR 1997
		COMPILED BY L.T.O.		<i>Michael King</i> Recorder of Titles
		SCALE 1:4000 LENGTHS IN METRES		
MAPSHEET MUNICIPAL CODE No. 111 (4845-41)	LAST UPI No 5000191 5000192	LAST PLAN No. D.24690	ALL EXISTING SURVEY NUMBERS TO BE CROSS REFERENCED ON THIS PLAN	

~~BALANCE PLAN~~

C 810157
~~6000782~~ RIGHT OF WAY (P.8117) 10.06 WIDE MARKED "ABCDEFGHIJKL" HEREON HAS BEEN DELETED PURSUANT TO REQUEST TO AMEND MADE UNDER SECTION 103 OF THE LOCAL GOVERNMENT (BUILDING & MISCELLANEOUS PROVISIONS) ACT No.96 OF 1993.

Nice Kawa
 RECORDER OF TITLES
 11 JUN 2009

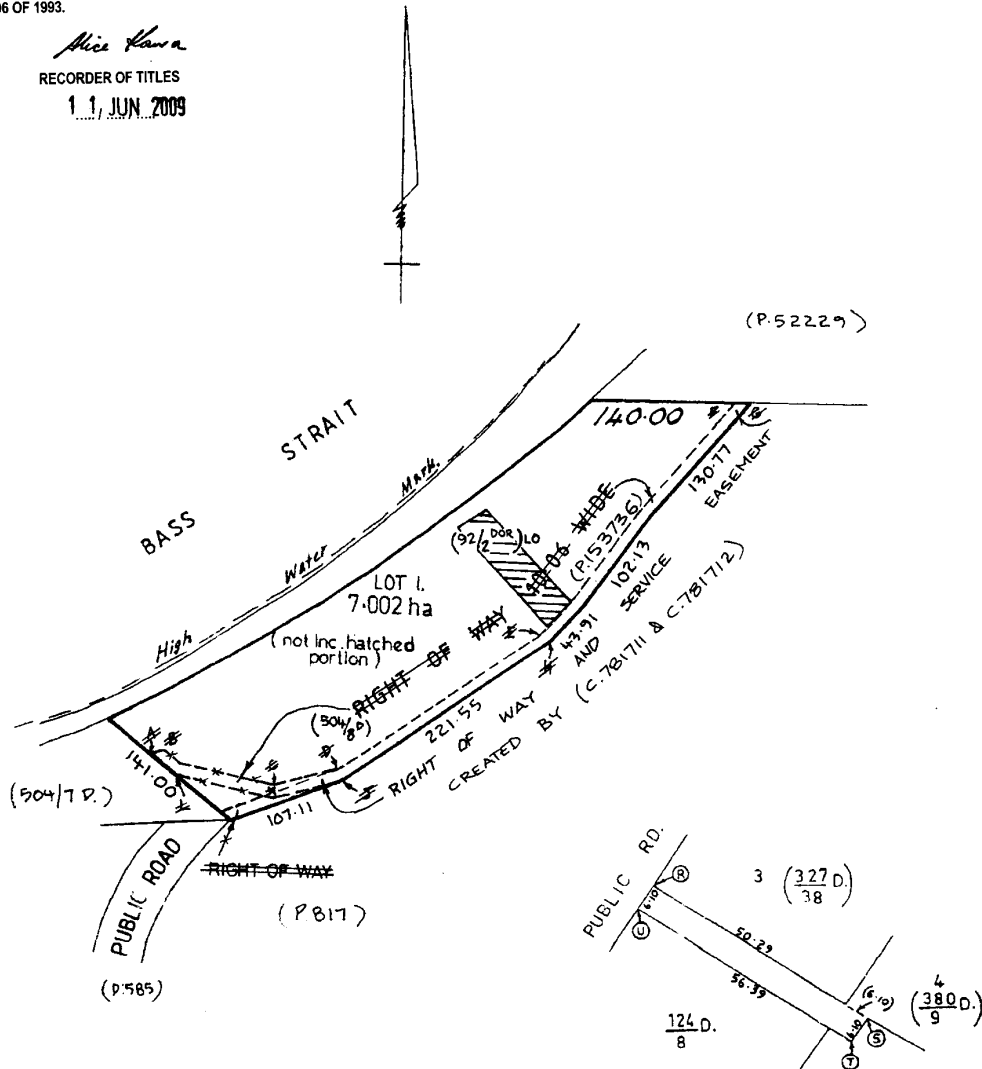

A 143